

APPENDIX C

AS-BUILT CLOSURE DRAWINGS

APPENDIX C

Drawing Title	Drawing No.
Cast-In-Place Concrete Cap No. 1 Shaft As-Built	10903-1C
Steel Grate Closure No. 2 Shaft As-Built	10903-2C
Monolithic Concrete Slab No. 1 Raise As-Built	10903-3C
Pre-Cast Concrete Panels and Cast-In-Place Concrete Cap No.2 Raise As-Built	10903-4C

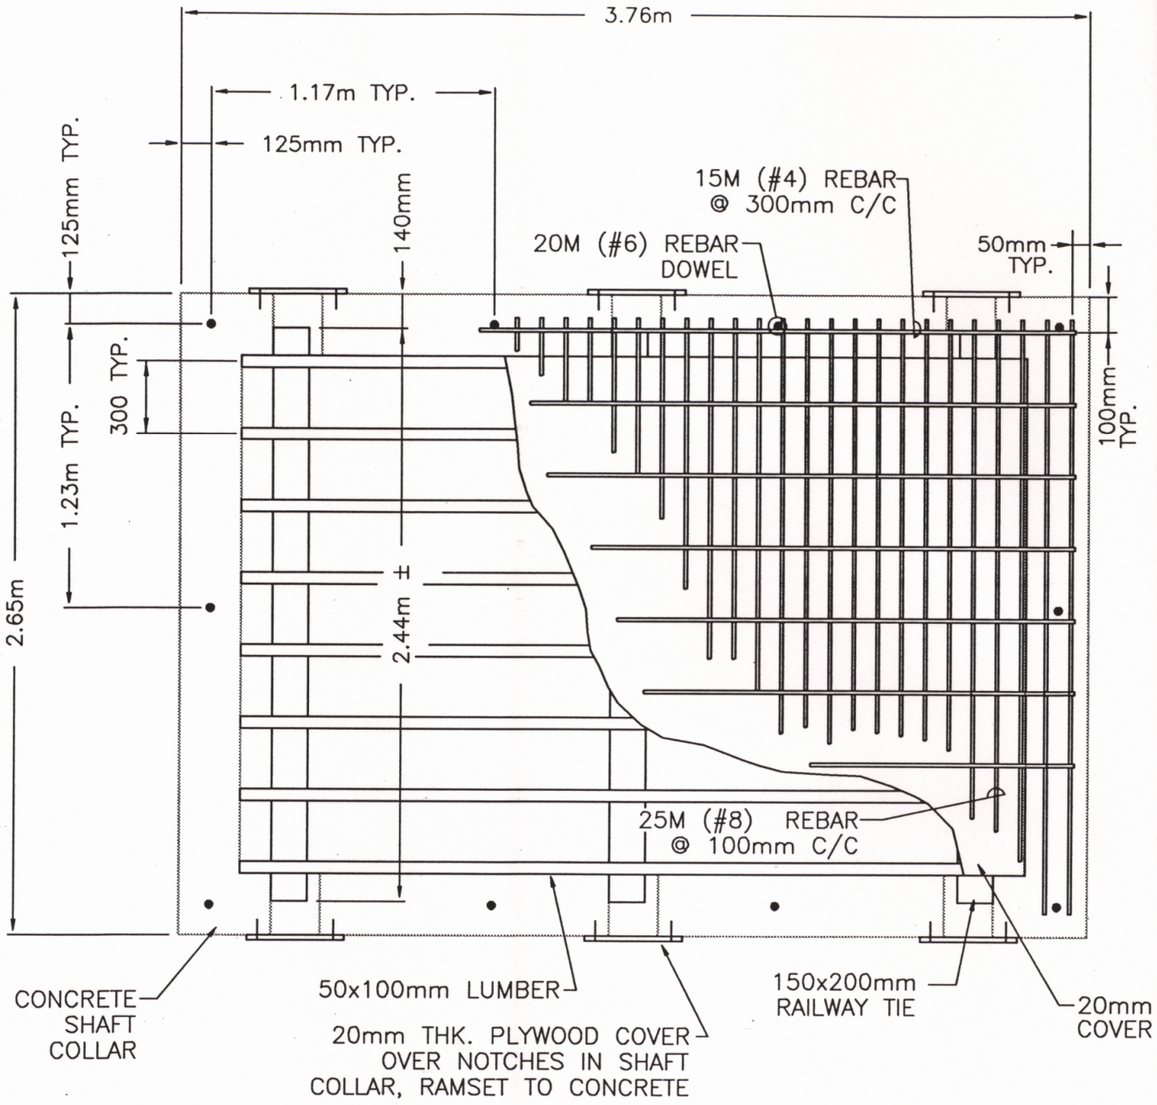


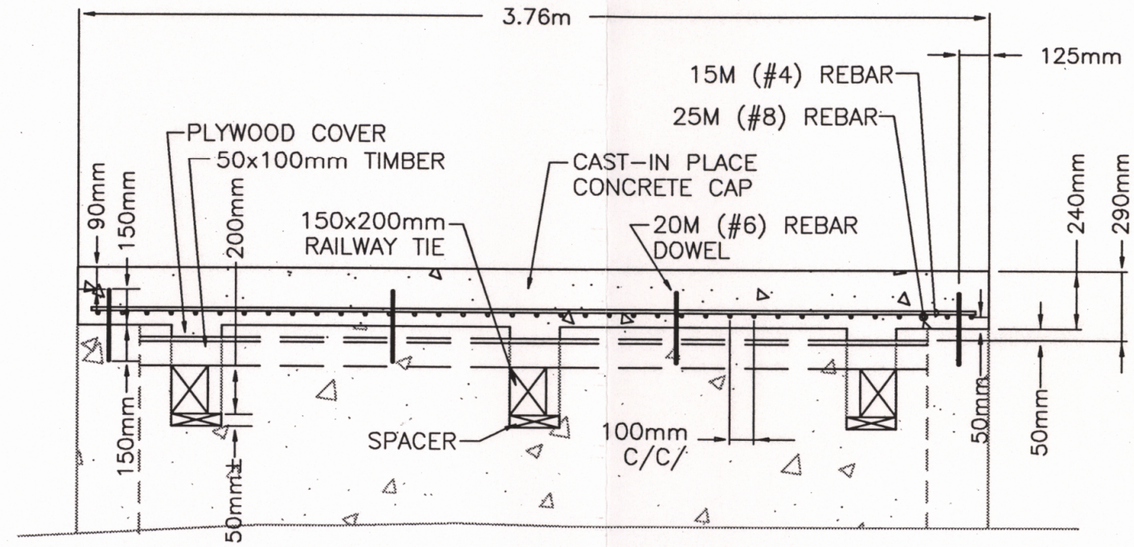


NOTES:

1. ALL DIMENSIONS IN MILLIMETRES UNLESS NOTED OTHERWISE.

Jacques, Whitford and Associates Limited	REFERENCE	SCALE : 1 : 25 DATE : 96/03/26 DRAWN BY : P.J.SOO APPROVED BY :	NOVA SCOTIA DEPARTMENT OF NATURAL RESOURCES SHAFT CAPPING DEMONSTRATION PROJECT STIRLING MINE, STIRLING, RICHMOND COUNTY, N.S.	CAST-IN-PLACE CONCRETE CAP DESIGN No. 1 SHAFT AS-BUILT	DRAWING NO. 10903-1C

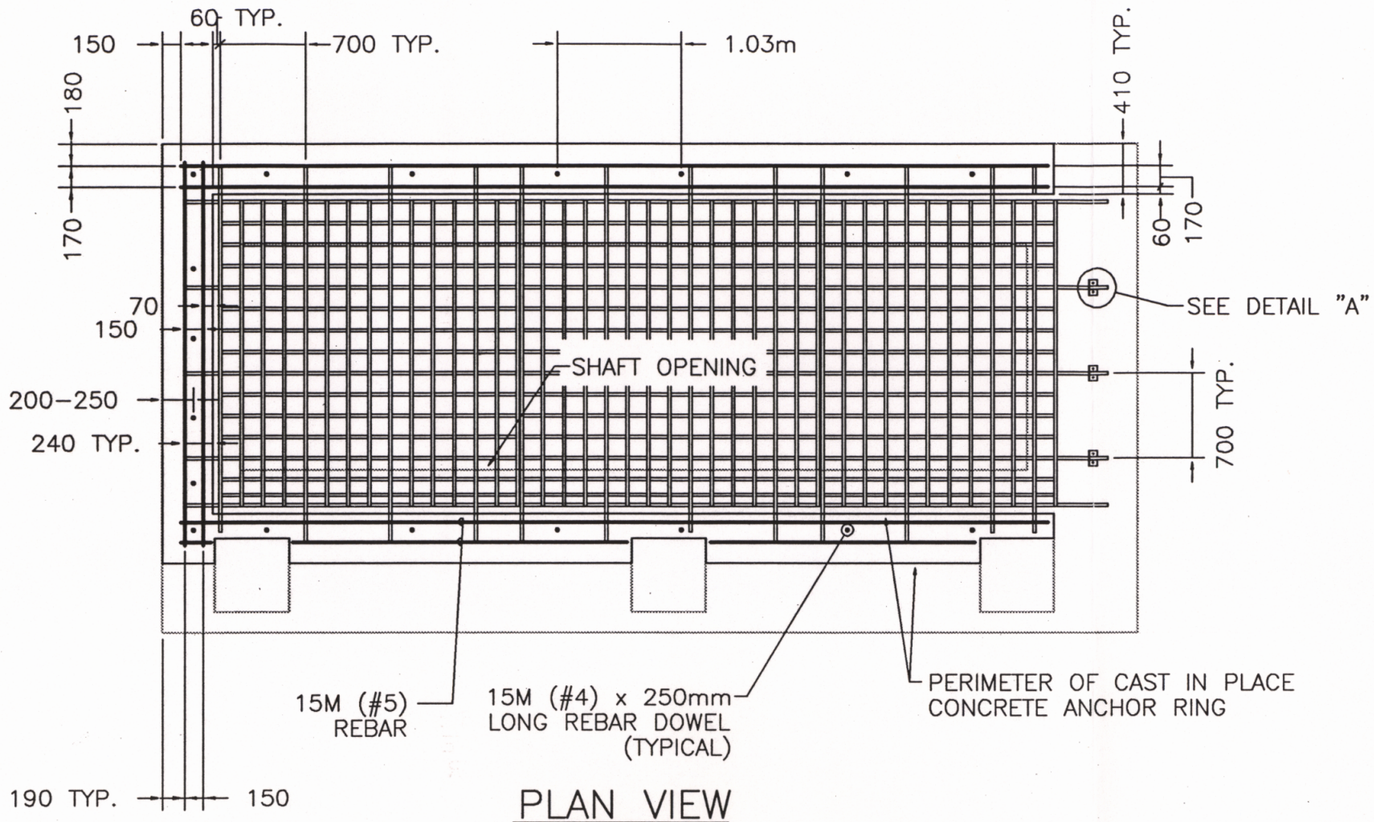


PLAN VIEW

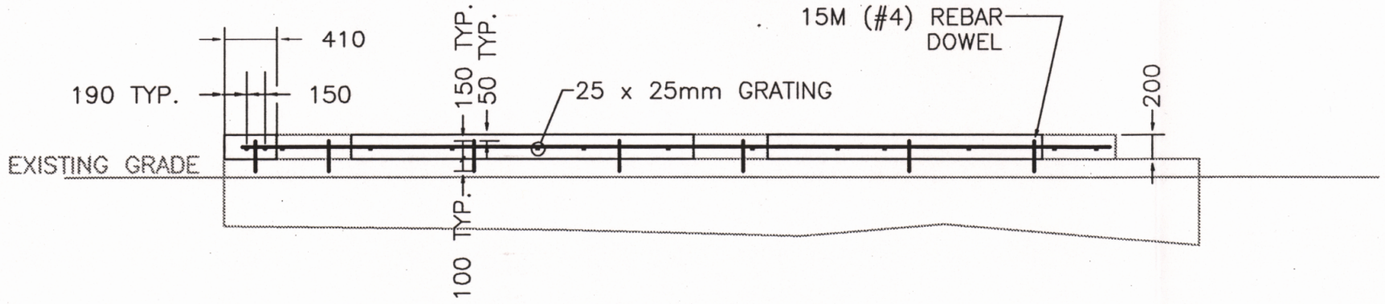


PROFILE

NOTES:

1. ALL DIMENSIONS IN MILLIMETRES UNLESS NOTED OTHERWISE.

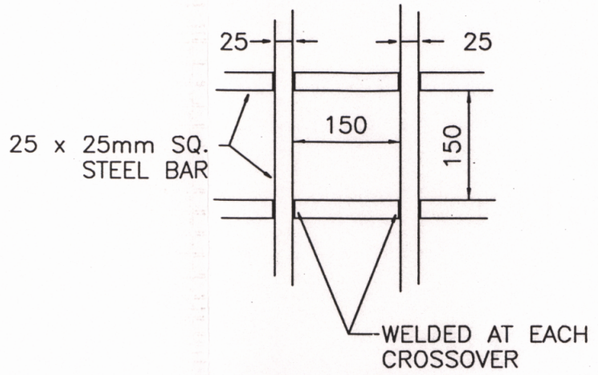


GRATE DETAIL

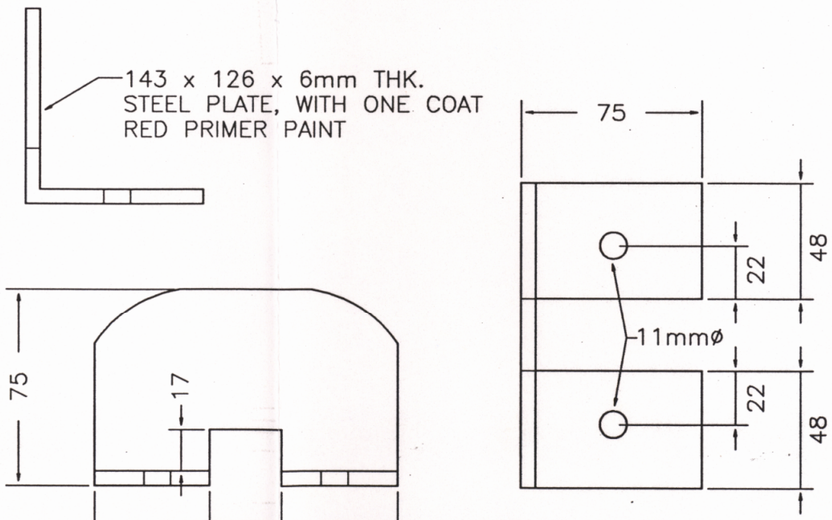


DETAIL "A"
FASTENING PLATE

Jacques, Whitford and Associates Limited	REFERENCE	SCALE : 1 : 50 DATE : 96/03/26 DRAWN BY : P.J.SOO APPROVED BY : R Morton	NOVA SCOTIA DEPARTMENT OF NATURAL RESOURCES SHAFT CAPPING DEMONSTRATION PROJECT STIRLING MINE, STIRLING, RICHMOND COUNTY, N.S.	STEEL GRATE CLOSURE No.2 SHAFT AS–BUILT	DRAWING NO. 10903–2C

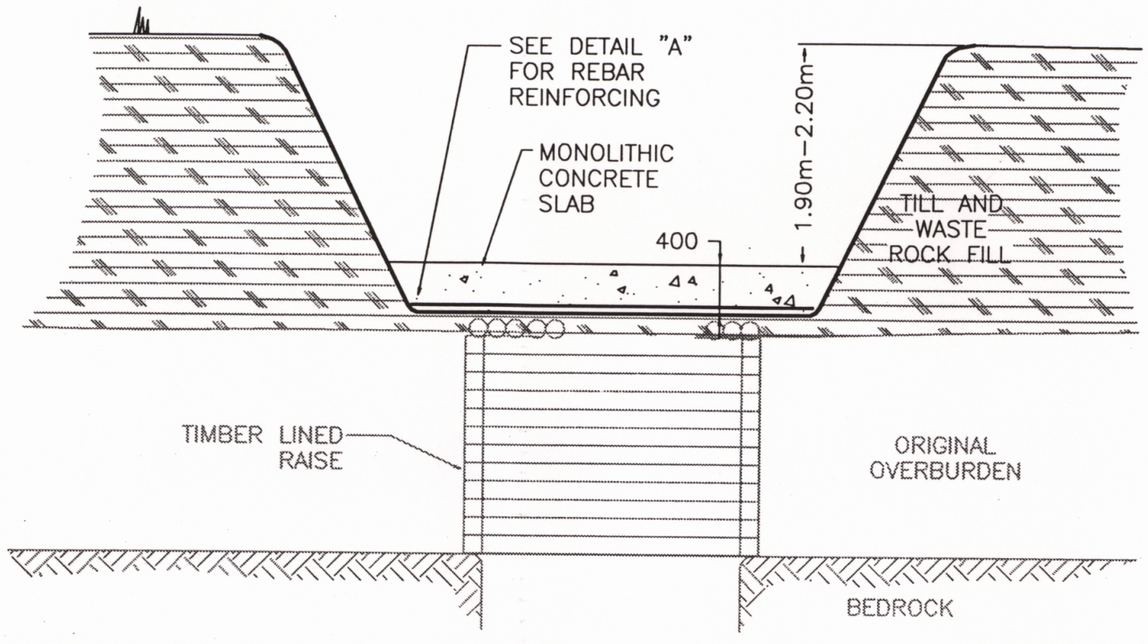


CAST–IN–PLACE CONCRETE MONOLITHIC SLAB DESIGN

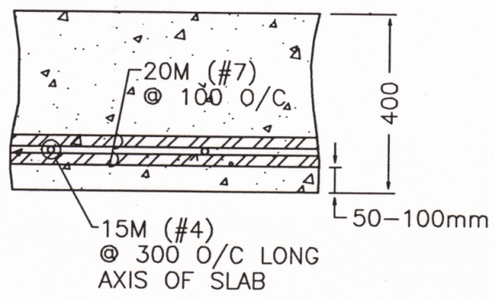

REBAR DETAIL


NOTES:

1. ALL DIMENSIONS IN MILLIMETRES UNLESS NOTED OTHERWISE.

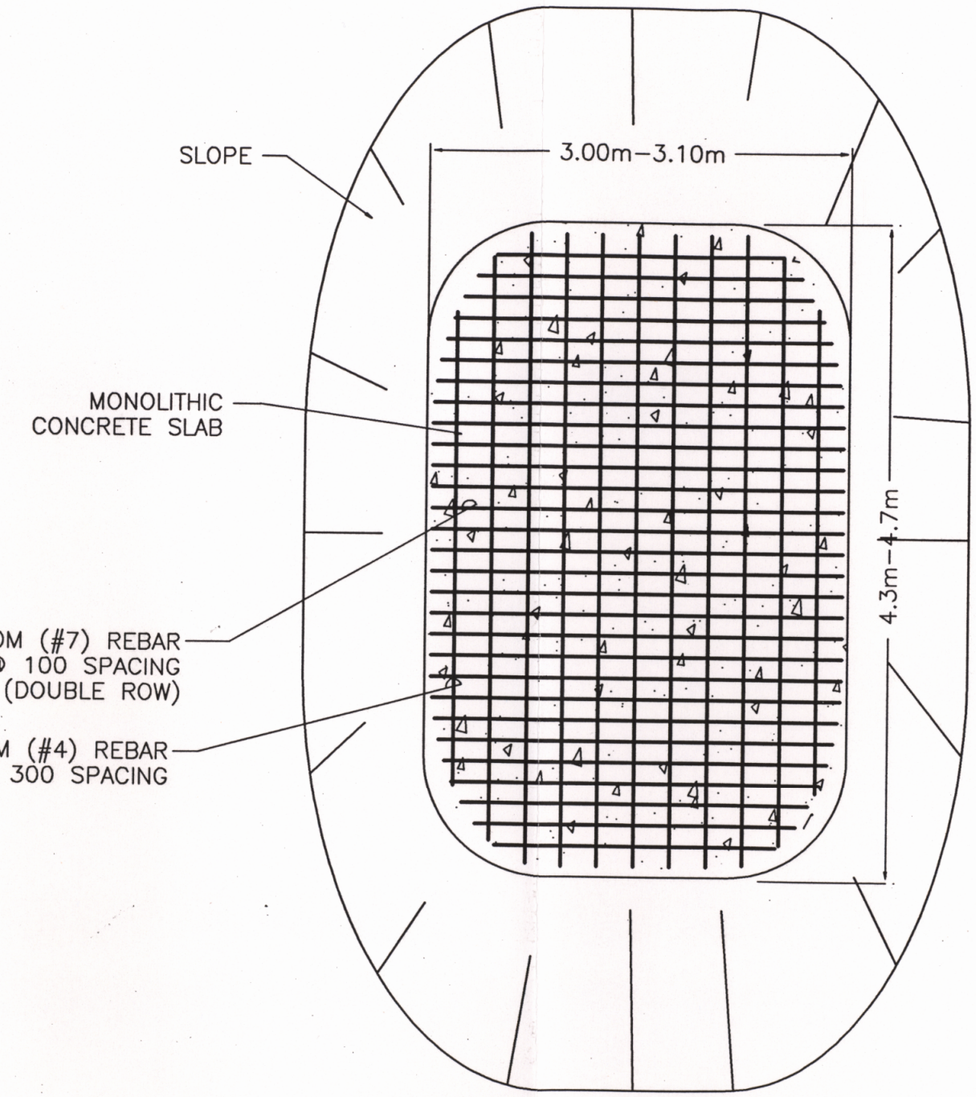


PLAN VIEW

Jacques, Whitford and Associates Limited	REFERENCE	SCALE : 1 : 50 DATE : 96/03/26 DRAWN BY : P.J.SOO APPROVED BY : B. Herter	NOVA SCOTIA DEPARTMENT OF NATURAL RESOURCES SHAFT CAPPING DEMONSTRATION PROJECT STIRLING MINE, STIRLING, RICHMOND COUNTY, N.S.	MONOLITHIC CONCRETE SLAB No.1 RAISE AS–BUILT	DRAWING NO. 10903–3C

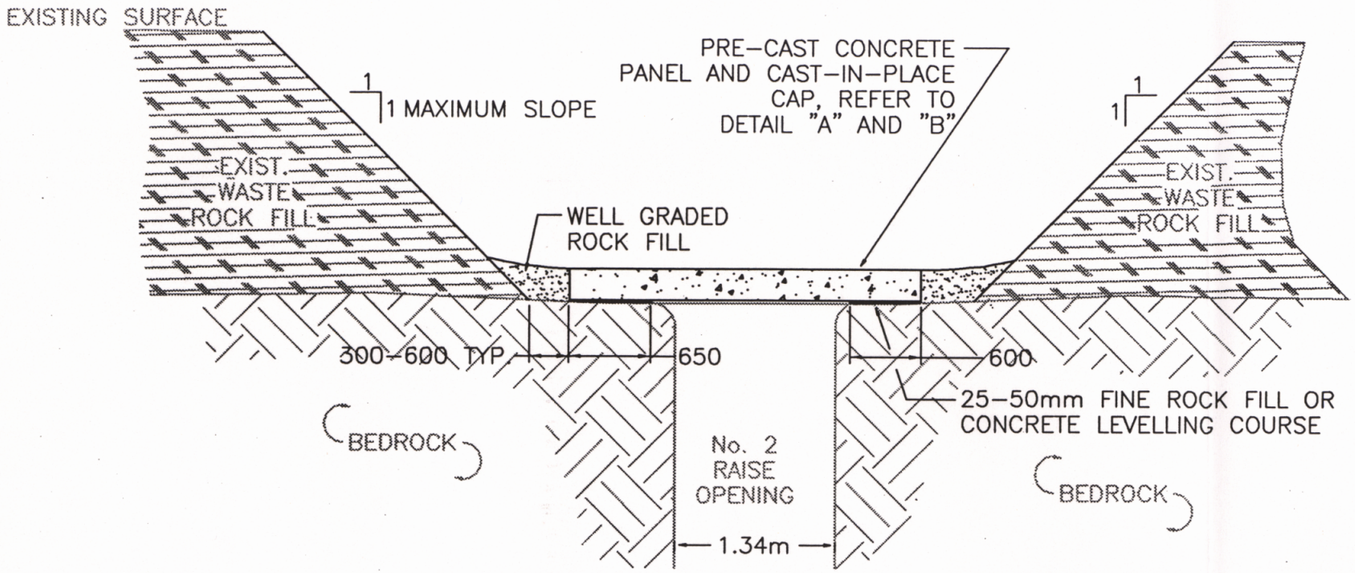


PROFILE VIEW

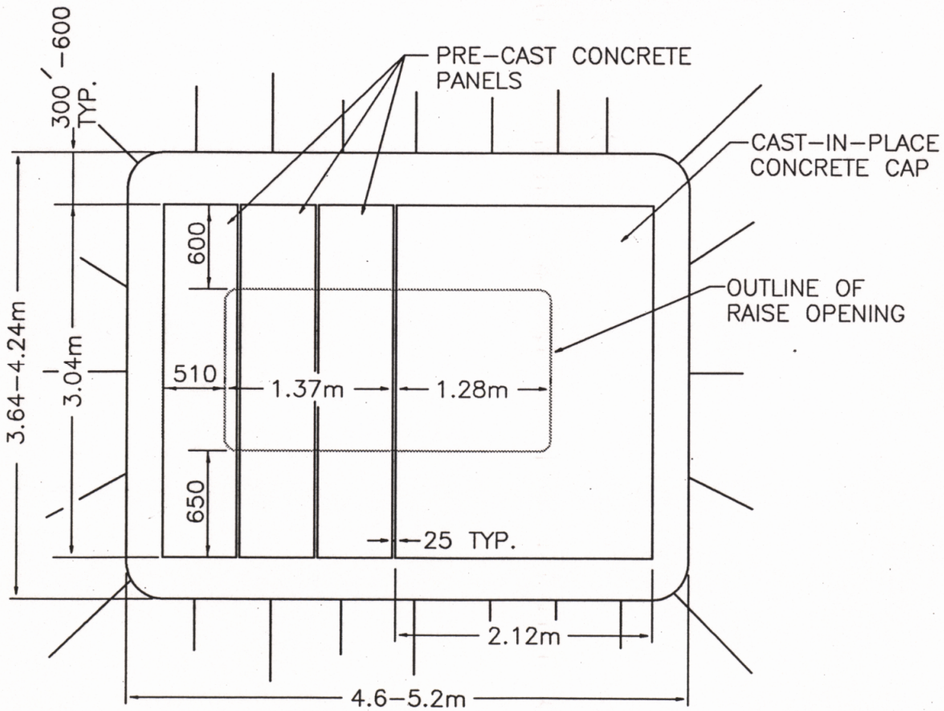

PLAN VIEW


NOTES:


1. ALL DIMENSIONS IN MILLIMETRES UNLESS NOTED OTHERWISE.

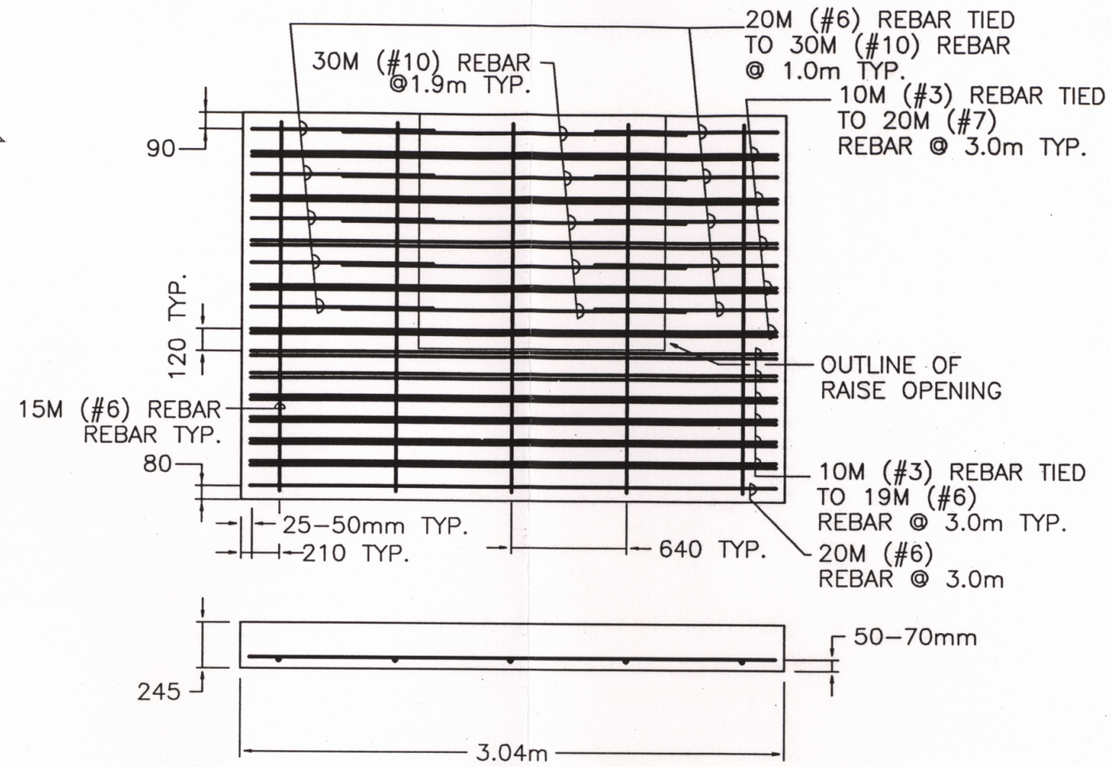

DETAIL "B" CAST-IN-PLACE CONCRETE CAP

N.T.S.

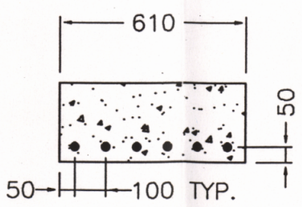

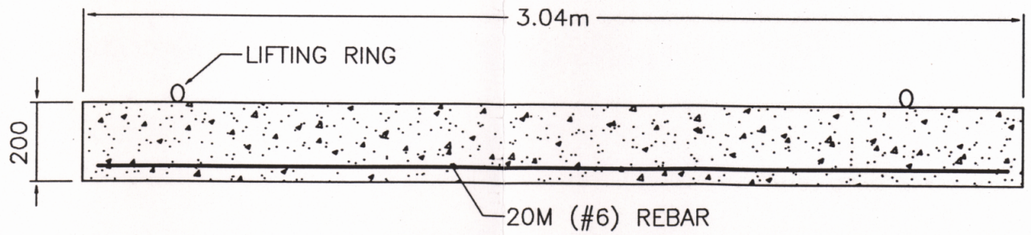

DETAIL "A" PRE-CAST CONCRETE PANEL

N.T.S.

Jacques, Whitford and Associates Limited	REFERENCE	SCALE : 1 : 50 DATE : 96/03/26 DRAWN BY : P.J.S00 APPROVED BY :	NOVA SCOTIA DEPARTMENT OF NATURAL RESOURCES SHAFT CAPPING DEMONSTRATION PROJECT STIRLING MINE, STIRLING, RICHMOND COUNTY, N.S.	PRE-CAST CONCRETE PANELS AND CAST IN PLACE CONCRETE CAP No. 2 RAISE AS-BUILT	DRAWING NO. 10903-4C